

DEVAL L. PATRICK
GOVERNOR

TIMOTHY P. MURRAY
LIEUTENANT GOVERNOR

The Commonwealth of Massachusetts

Executive Office for Administration and Finance

Division of Capital Asset Management

One Ashburton Place

Boston, Massachusetts 02108

Tel: (617) 727-4050

Fax: (617) 727-5363

JAY GONZALEZ
SECRETARY, ADMINISTRATION
& FINANCE

CAROLE CORNELISON
COMMISSIONER

April 20, 2011

Kimberly N. Tisa
Region 1 PCB Coordinator
U.S. Environmental Protection Agency New England
5 Post Office Square, Suite 100
Mail Code: OSRR07-2
Boston, MA 02109-3912

**RE: Self-Implementation PCB Remediation Plan
Cost-Removal Alternative Study Program, Addendum 1
Salem State University Library
360 Lafayette Street, Salem, Massachusetts.**

Dear Ms. Tisa:

The Division of Capital Asset Management (DCAM) is pleased to submit this addendum to our Self Implementation Plan (SIP), prepared in accordance with 40CFR761.61(a) and dated February 11, 2011 for the above-referenced Site. Below is a description of the addendum for the Salem State Library SIP:


DCAM requests that the panels noted on the attached tables be added to the scope of work of the approved SIP. Please note that the additional panels will be prepared using the procedures described in the SIP, and the work will be subject to all of the procedures, controls, protective measures, handling, packaging, testing, and disposal requirements in the approved SIP.

All caulk will be managed as a PCB Bulk Product Waste in accordance with 40CFR761.62. Masonry within 12 inches of the caulk joint will be managed as PCB bulk remediation waste greater than 50 ppm in accordance with 40CFR761.61(a), and material greater than 12 inches from the caulk joint will be managed as PCB bulk remediation waste greater than 1 ppm but less than 50 ppm in accordance with 40CFR761.61(a)(5)(v)(A), although this material is considered an "excluded product" as defined in 40CFR761.3.

Also attached are drawings highlighting the additional interior and exterior panels that are included in this addendum; Drawing C1.001 and Drawings A1.001 – A1.008 prepared by Pare Corporation.

If you have any questions or concerns regarding the cleanup, or if we may be of additional assistance regarding the project, please do not hesitate to contact me at 617-727-4030, ext. 207.

Sincerely,
Division of Capital Asset Management

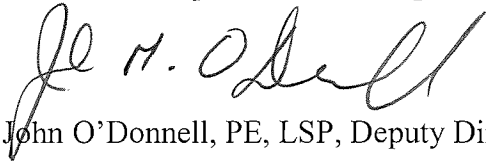A handwritten signature in black ink, appearing to read "John O'Donnell". The signature is fluid and cursive, with the first name "John" and last name "O'Donnell" clearly distinguishable.

John O'Donnell, PE, LSP, Deputy Director

Cc: A. Soll (Salem State University)
B. Novak (DCAM)

M. Swingle (DCAM)

Attachments

Table A.1.1

Table A.1.2

Drawings C1.001 and A1.001-A1.008 dated 2-15-2011 Prepared by Pare Corporation

Table A.1.1 Summary of Exterior Panel Removal Designations for the Cost Study SIP and Addendum #1, Salem State Library, Salem State University, Salem, Massachusetts

Panel Face Designation *	Ground Fl. (Panel #0)*	Lower Level (Panel #1)*	1 st Floor (Panel #2)*	2 nd Floor (Panel #3)*	3 rd Floor (Panel #4)*	4 th Floor (Panel #5)*
A	Addendum ¹	Addendum	Cost Study ²	Addendum	Addendum	Cost Study
B	Addendum(f)	Addendum	Addendum	Addendum	Cost Study	Cost Study(w)
C	Addendum(f)	Addendum(w)	Cost Study(w)	Cost Study(w)	Cost Study(w)	Cost Study
D	Addendum(f)	Addendum	Cost Study	Addendum	Addendum	Cost Study(w)
E	Addendum	Addendum	Cost Study	Addendum	Cost Study	Cost Study
F	Addendum	Addendum	Cost Study	Addendum	Cost Study	Cost Study
G	Addendum(d)	Cost Study	Cost Study	Cost Study	Cost Study	Cost Study(w)
H	Addendum	Cost Study	Cost Study	Cost Study	Cost Study	Cost Study
I	Addendum	Cost Study	Cost Study	Cost Study	Cost Study	Cost Study
J	Addendum(l,d)					Cost Study
K	Addendum					Cost Study
L	Addendum					
M	Addendum					
N	Addendum(l)					
X						Addendum
Total Cost Study	0	3	8	4	7	11
Total Addendum	11	6	1	5	2	1
Total Panels	11	9	9	9	9	12

¹Addendum: Indicates panel is proposed to be removed in the work covered by Addendum #1

²Cost Study: Indicates panel will be removed in the work covered by the Cost Study SIP

(d): indicates a metal door panel

(f): indicates wall panel is foundation [concrete], will be removed as part of the foundation demolition work in Phase I

(l): indicates panel contains or consists of a metal louver

(w): indicates panel is 100% window

All panel removal involving masonry in the work covered by the Addendum will be conducted using Alternative Method A, B or C as described in the SIP dated February 11, 2011.

*Panel # designates the floor on which the panel is located, and the face designation locates the panel horizontally on a particular floor; beginning on the north side, progressing east then south, and terminating at the west face of the building. Individual panels are designated in drawings attached to the SIP by the Panel #, then the Panel Face Designation. For example, the A panel on the second floor would be designated as Panel 3A.

Table A.1.2 Summary of Interior Panel Removal Designations for the Cost Study SIP and Addendum #1, Salem State Library, Salem State University, Salem, Massachusetts


Panel #*	Ground Fl. (Panel #0)	Lower Level (Panel #1)	1 st Floor (Panel #2)	2 nd Floor (Panel #3)	3 rd Floor (Panel #4)	4 th Floor (Panel #5)
1	Addendum ¹	Cost Study ²	Addendum	Addendum	Addendum	Cost Study
2	Addendum	Cost Study	Addendum	Addendum	Addendum	Cost Study
3	Addendum	Cost Study	Addendum	Addendum	Addendum	Cost Study
3A		Cost Study				
4	Addendum	Cost Study	Addendum	Cost Study	Cost Study	Cost Study
5	Addendum	Cost Study	Addendum	Addendum	Addendum	Addendum
6	Addendum	Cost Study	Addendum	Cost Study	Cost Study	Cost Study
7	Addendum	Cost Study		Addendum	Addendum	Addendum
8	Addendum	Cost Study				
9	Addendum	Addendum				
10	Addendum	Addendum				
11	Addendum	Addendum				
12	Addendum					
13	Addendum					
14	Addendum					
15	Addendum					
16	Addendum					
Total Cost Study	0	9	0	2	2	5
Total Addendum	16	3	6	5	5	2
Total Interior Panels	16	12	6	7	7	7

¹Addendum: Indicates panel is proposed to be removed in the work covered by Addendum #1

²Cost Study: Indicates panel will be removed in the work covered by the Cost Study SIP


All panel removal involving masonry in the work covered by the Addendum will be conducted using Alternative Method A, B or C as described in the SIP dated February 11, 2011.

*Panel # designates the wall section on each floor.

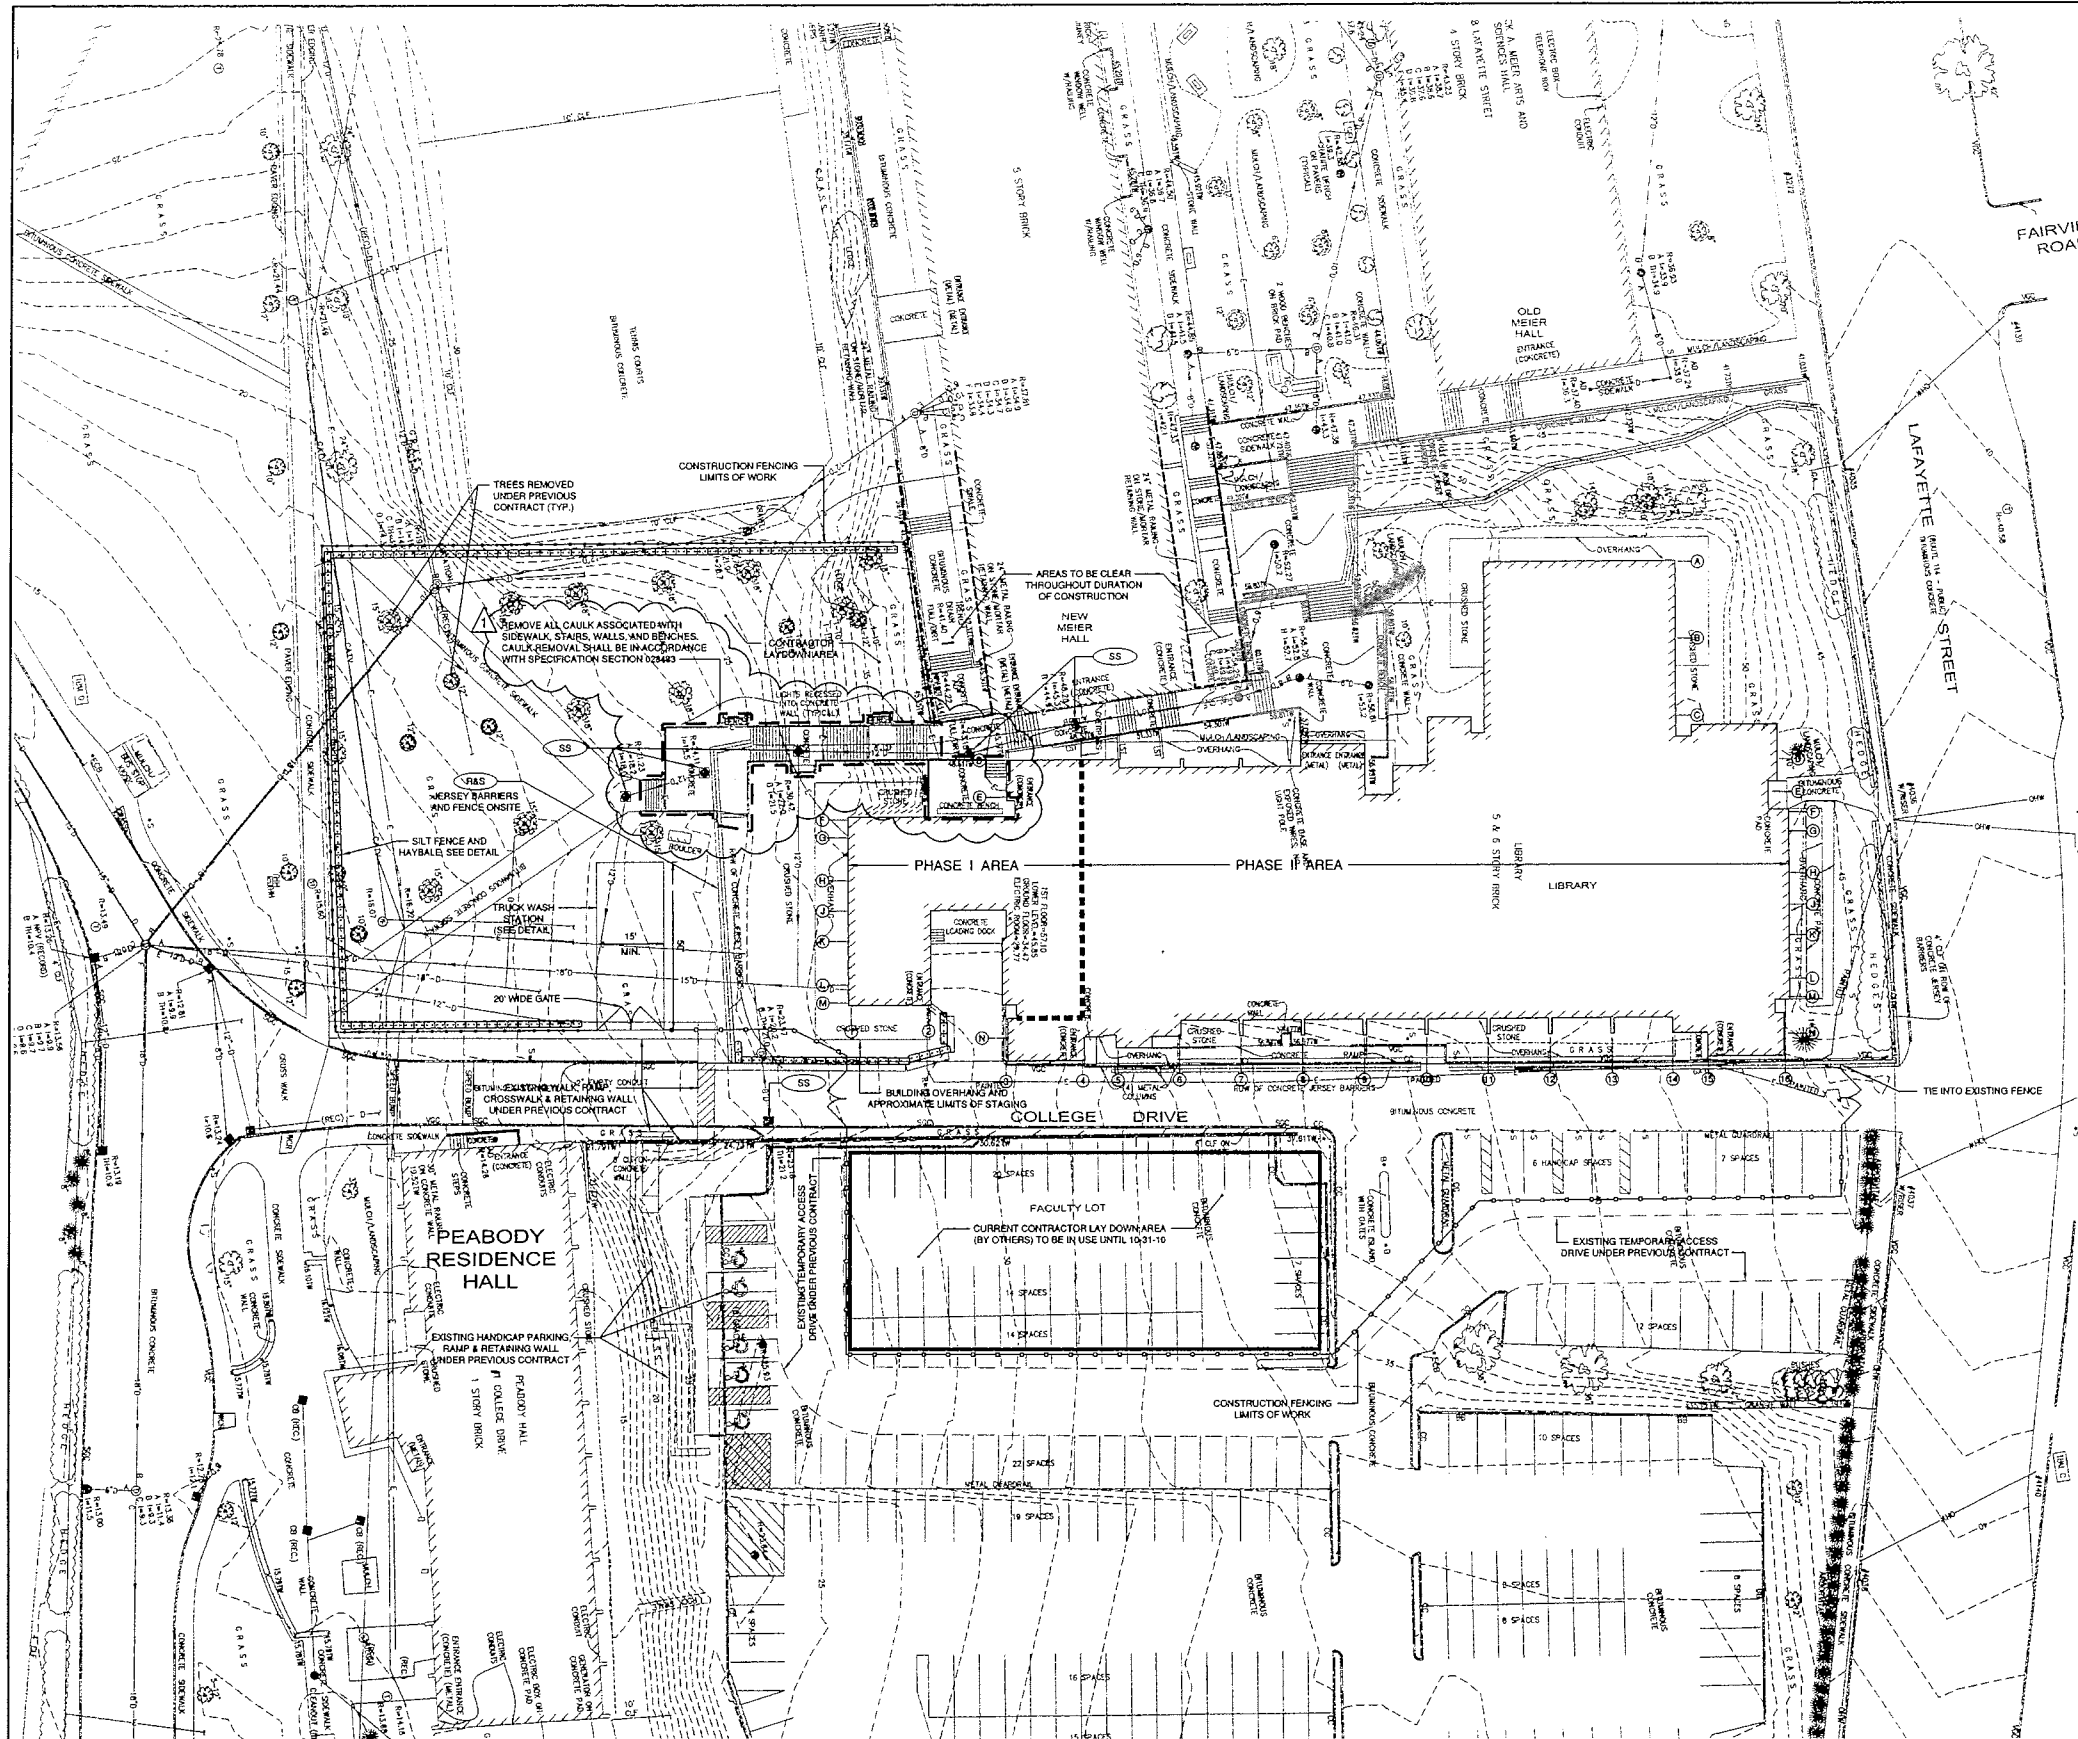

NOTES:


1. PROJECT MAY OVERLAP WITH EXISTING CONTRACTS. CONTRACTOR TO COORDINATE WITH ON-SITE CONTRACTORS.
2. COLLEGE DRIVE SHALL REMAIN OPEN AND OPERATIONAL TO ONE WAY TRAFFIC. USE TEMPORARY ROAD FOR UNIVERSITY TRAFFIC. USE COLLEGE DRIVE FOR ABATEMENT AND DEMO ONLY.
3. WORK SHALL BE SCHEDULED SO PEDESTRIAN ACCESS IS MAINTAINED AND COMPLIANT WITH AMERICAN DISABILITY ACT (ADA) AND MASSACHUSETTS ARCHITECTURAL ACCESS BOARD (MAAB).
4. CONTRACTOR SHALL BE RESPONSIBLE FOR OBTAINING AND PAYING FOR ALL TEMPORARY POWER.
5. COORDINATE ALL LOCKS WITH SALEM FIRE DEPARTMENT AND SALEM STATE COLLEGE.
6. SOME SITE WORK SHOWN IS BASED ON DESIGN PLANS AND NOT AS-BUILT CONDITIONS.
7. TOPOGRAPHIC DATA, PROPERTY LINE INFORMATION, AND EXISTING SITE FEATURES WERE OBTAINED FROM A PLAN ENTITLED "EXISTING CONDITIONS PLAN", PREPARED BY NITSCHE ENGINEERING, DATED FEBRUARY 12, 2010.
8. TEMPORARY ACCESS DRIVE, HANDICAP PARKING, RAMPS AND WALKWAY WERE OBTAINED FROM PREVIOUS CONTRACT PLANS ENTITLED "ELECTRICAL RELOCATION SALEM STATE COLLEGE" DATED 03-08-2010.
9. BUILDING PLANS REFERENCE "LIBRARY BUILDING STATE COLLEGE AT SALEM" ORIGINAL DESIGN PLANS PREPARED BY DESMOND AND LORD, INC. DATED FEBRUARY 4, 1969.

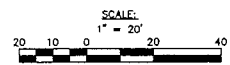

Division of Capital Asset Management
D C A M
Building for the Commonwealth

Office of Planning
Design and Construction

McCormack Building
One Ashburton Place
Boston MA 02108
617 727 4050
www.mass.gov/cam

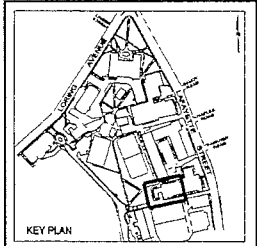

Project Name:
**COST-REMOVAL
ALTERNATIVE
PROGRAM
SALEM STATE COLLEGE**

MA State Project Number
SSA0701-DC1

Project Location
360 Lafayette Street
Salem, Massachusetts

Project Engineer

PARE CORPORATION
ENGINEERS - ARCHITECTS - PLANNERS
18 LINCOLN ROAD, SUITE 100
PO BOX 14100
Salem, MA 01970
978-743-1700

Project Consultant

PARE CORPORATION
ENGINEERS - ARCHITECTS - PLANNERS
18 LINCOLN ROAD, SUITE 100
PO BOX 14100
Salem, MA 01970
978-743-1700

Site Number: SSA00
CAMIS Number: SSA00
Building Number: 531SSC0340, Library
Secretariat: Dept. of Higher Education


Original Issue Date
09 - 13 - 2010

Revisions	No.	Description	Date
1	SKC-1		2-15-11

Pen Name:

SITE PLAN

Drawing Number:
C1.001
Drawing 2 of 21

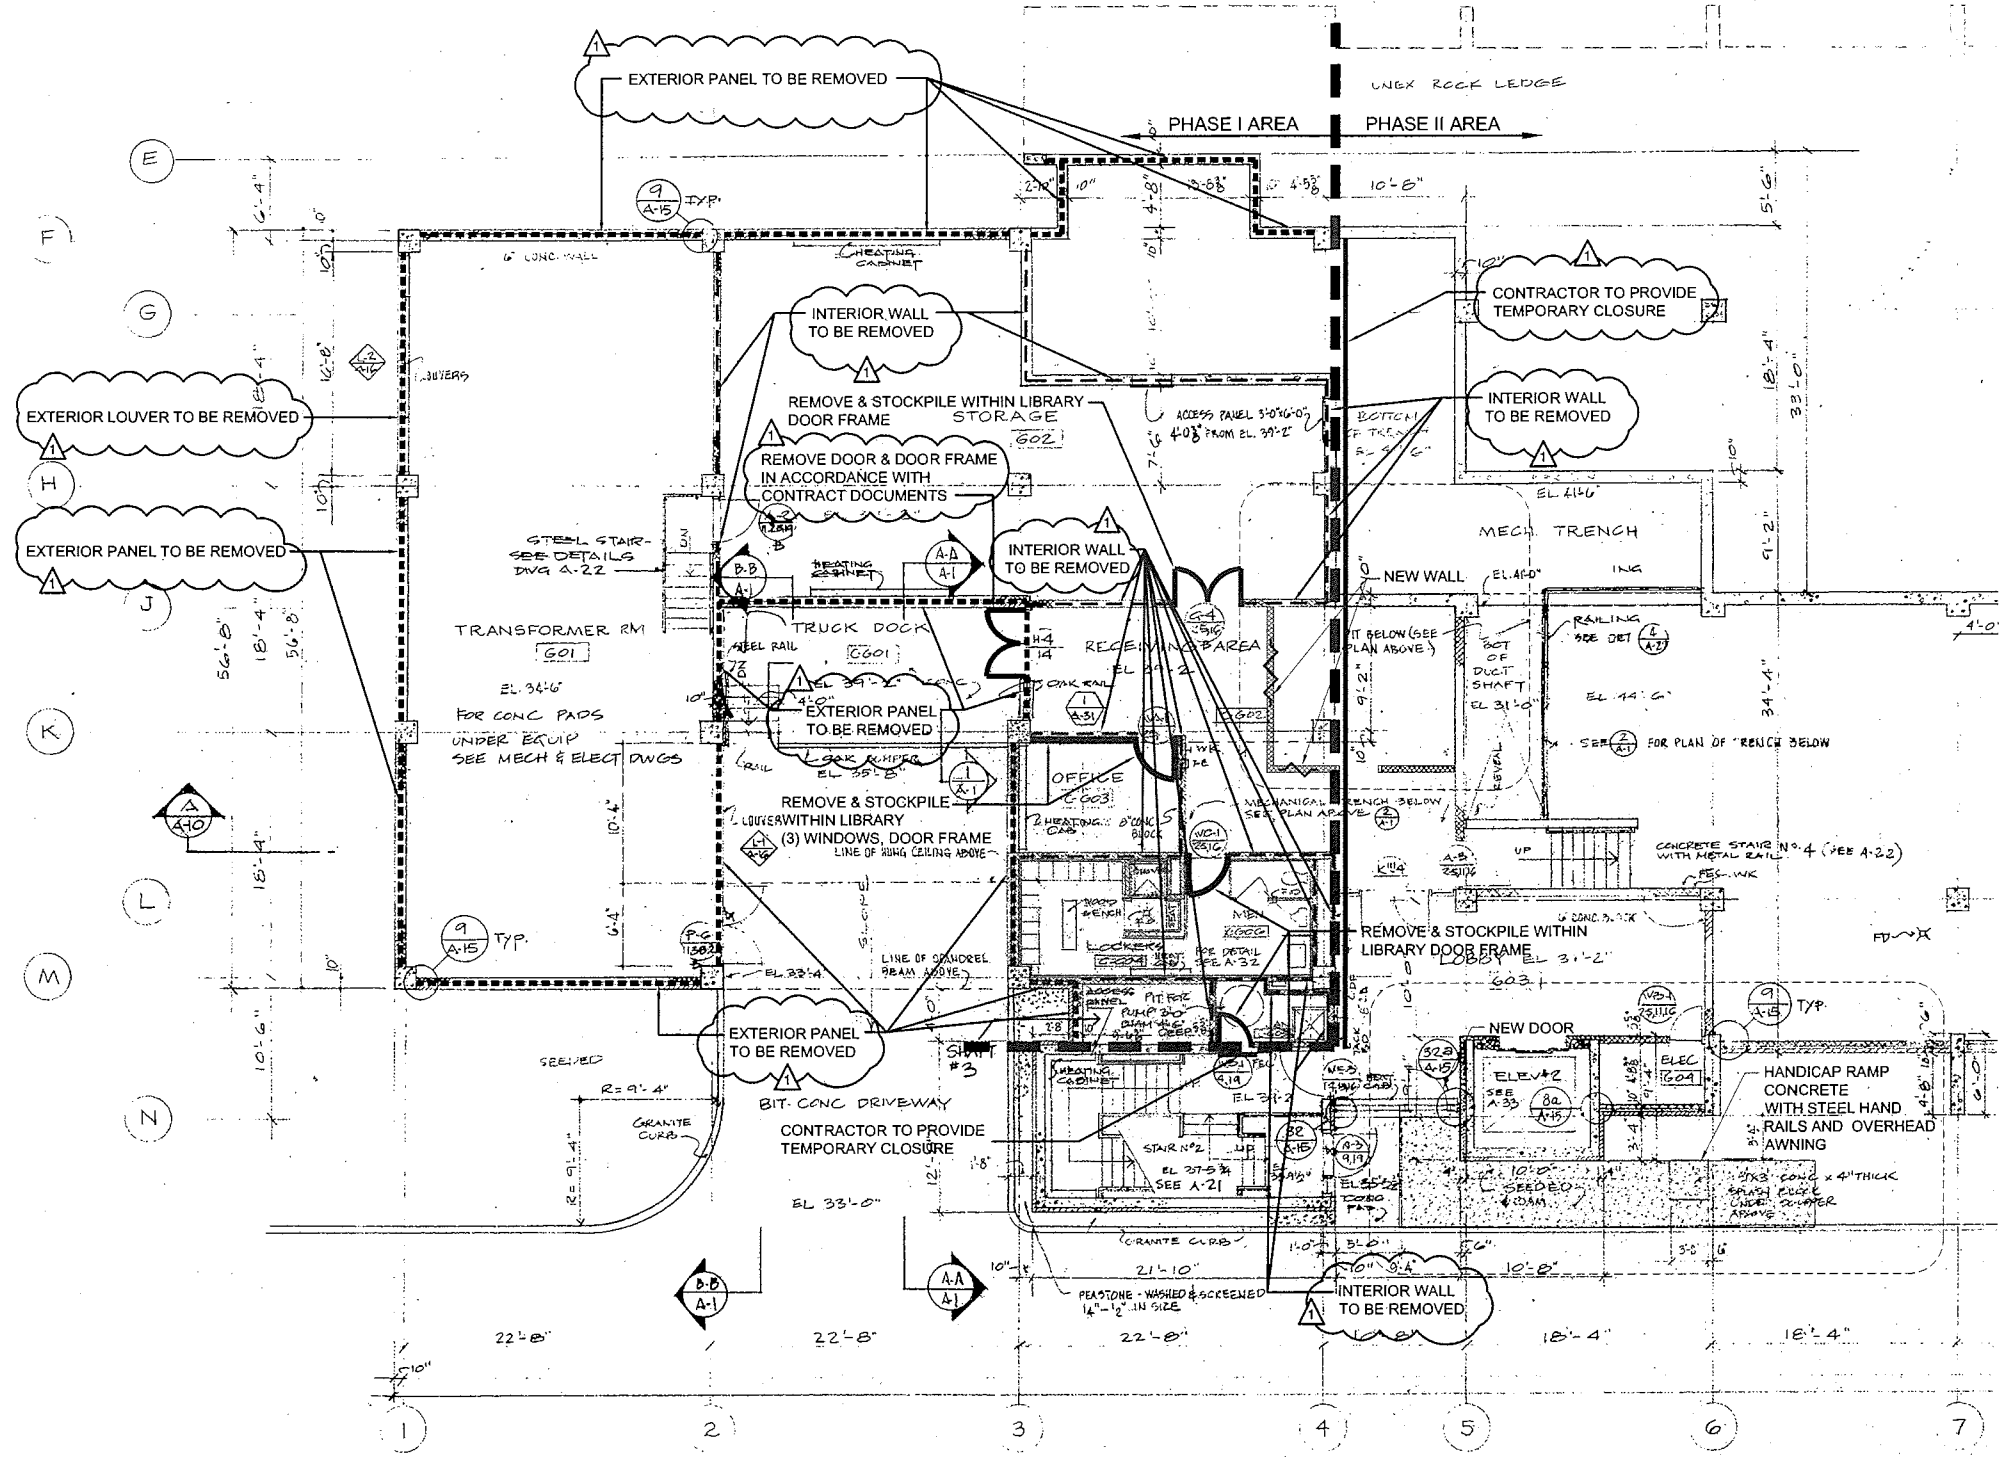

LEGEND:

CHANGE FROM ORIGINAL DESIGN, BASED ON VISUAL OBSERVATIONS.

PLAN NOTE:

PLANS OF EXISTING LIBRARY ARE DESIGN PLANS AND ARE NOT AS-BUILT CONDITIONS. ACTUAL CONDITIONS MAY VARY FROM THOSE SHOWN ON PLANS.

ELEVATION DATUM:

ELEVATIONS ON CIVIL (C-SERIES) DRAWINGS IN THIS CONTRACT REFER TO NGVD 1929. DEMOLITION (A-SERIES) DRAWINGS IN THIS CONTRACT SHOW ELEVATIONS REFERENCED TO A DATUM ABOUT 4.7 FEET BELOW NGVD 1929. ELEVATIONS ON THIS DRAWING CAN BE CONVERTED TO NGVD ELEVATIONS BY SUBTRACTING 4.7 FEET FROM THE VALUE SHOWN.


GYPSUM WALL REMOVED UNDER PREVIOUS CONTRACT



Division of Capital Asset Management
D.C.A.M.
Building for the Commonwealth

Office of Planning
Design and Construction

McCormack Building
One Ashburton Place
Boston MA 02108
617 727 4050
www.mass.gov/cam

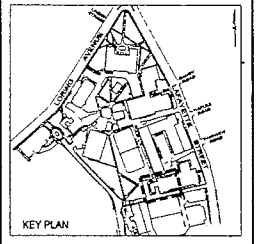

Project Name:
**COST-REMOVAL
ALTERNATIVE
PROGRAM
SALEM STATE COLLEGE**

MA State Project Number
SSA0701-DC1

Project Location
360 Lafayette Street
Salem, Massachusetts

Project Engineer

PARE CORPORATION
ENGINEERS, ARCHITECTS, PLANNERS
10 LINDSEY ROAD, SUITE 101
ROSLINDALE, MA 02126
617-552-1713

Project Number 10108.00

Project Consultant

PARE CORPORATION
ENGINEERS, ARCHITECTS, PLANNERS
10 LINDSEY ROAD, SUITE 101
ROSLINDALE, MA 02126
617-552-1713


Site Number: SSA00
CAMS Number: SSA00
Building Number: 531SSC0340, Library
Secretariat: Dept. of Higher Education

Original Issue Date
09 - 13 - 2010

Revisions	No.	Description	Date
1	SKC-1		2-15-11

Plan Name:
**PHASE I - EXISTING
GROUND LEVEL
FLOOR PLAN**

Drawing Number:
A1.001
Drawing 4 of 21

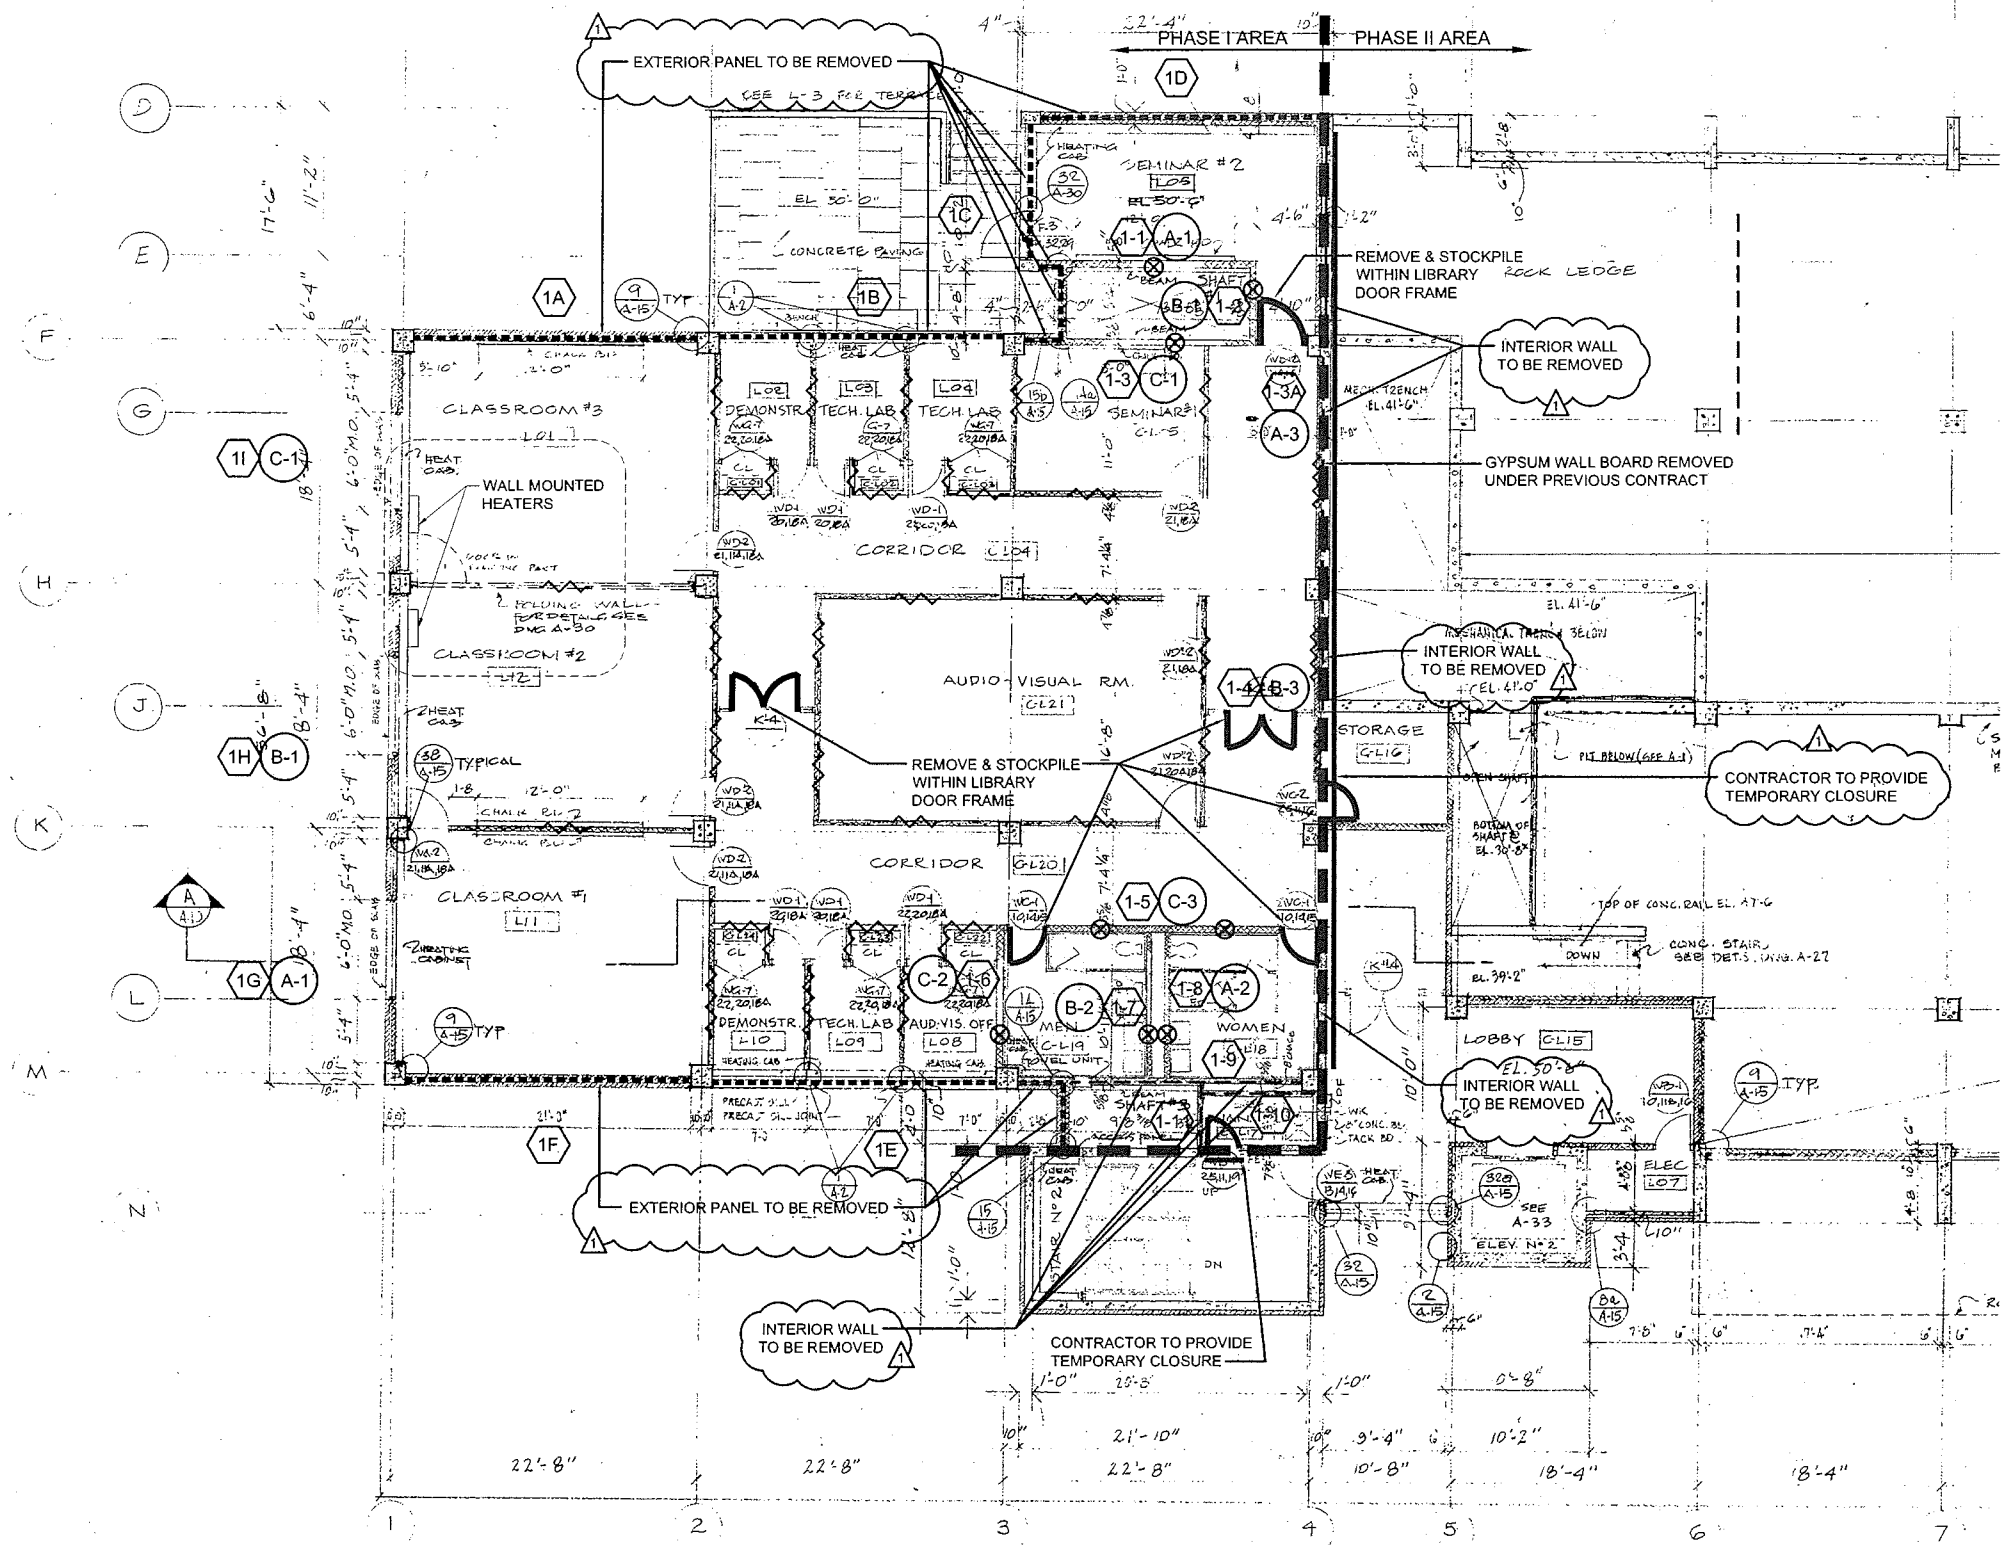

LEGEND:

CHANGE FROM ORIGINAL DESIGN, BASED ON VISUAL OBSERVATIONS.

ELEVATION DATUM:

ELEVATIONS ON CIVIL (C-SERIES) DRAWINGS IN THIS CONTRACT REFER TO NGVD 1929. DEMOLITION (A-SERIES) DRAWINGS IN THIS CONTRACT SHOW ELEVATIONS REFERENCED TO A DATUM ABOUT 4.7 FEET BELOW NGVD 1929. ELEVATIONS ON THIS DRAWING CAN BE CONVERTED TO NGVD ELEVATIONS BY SUBTRACTING 4.7 FEET FROM THE VALUE SHOWN.

PLAN NOTES:

- PLANS OF EXISTING LIBRARY ARE DESIGN PLANS AND ARE NOT AS-BUILT CONDITIONS. ACTUAL CONDITIONS MAY VARY FROM THOSE SHOWN ON PLANS.
- CONTRACTOR TO PROVIDE FLOOR CLOSURE OR HANDRAILS AT MECHANICAL SHAFT TO CONFORM WITH OSHA.
- CONTRACTOR TO PROVIDE FALL PROTECTION AT EDGE OF FLOOR WHERE EXTERIOR PANELS ARE REMOVED. FALL PROTECTION SHALL REMAIN AFTER CONTRACTOR LEAVES THE SITE.

1-5

INTERIOR PANEL DESIGNATION

1G

EXTERIOR PANEL DESIGNATION

A-1

PANEL TO BE REMOVED
METHOD OF REMOVAL (LETTER DESIGNATES METHOD - NUMBER DESIGNATES TRIAL)

⊗


REMOVE INTERIOR CMU WALL UNDER THIS CONTRACT

~~~~~

GYPSUM WALL REMOVED UNDER PREVIOUS CONTRACT

0 5 10  
APPROXIMATE SCALE, FEET

Division of Capital Asset Management  
**D.C.A.M.**  
Building for the Commonwealth  
  
Office of Planning  
Design and Construction  
  
McCormack Building  
One Ashburton Place  
Boston MA 02108  
617 727 4050  
www.mass.gov/cam

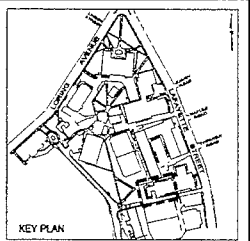

Project Name:  
**COST-REMOVAL  
ALTERNATIVE  
PROGRAM  
SALEM STATE COLLEGE**

MA State Project Number  
SSA0701-DC1

Project Location  
360 Lafayette Street  
Salem, Massachusetts

Project Engineer  
**PARE CORPORATION**  
DESIGNER - ENGINEER - PLANNER  
18 DORCHESTER STREET, 18TH FLOOR  
PO BOX 100, NEWTON, MA 02459  
TEL: 617-552-1100 FAX: 617-552-1101

Project Number 10108.00

Project Consultant  
**PARE CORPORATION**  
DESIGNER - ENGINEER - PLANNER  
18 DORCHESTER STREET, 18TH FLOOR  
PO BOX 100, NEWTON, MA 02459  
TEL: 617-552-1100 FAX: 617-552-1101


Site Number: SSA00  
CAMS Number: SSA00  
Building Number: 531SSC0340, Library  
Secretariat: Dept. of Higher Education

Original Issue Date  
09 - 13 - 2010

| Revisions | No.   | Description | Date    |
|-----------|-------|-------------|---------|
| 1         | SKC-1 |             | 2-15-11 |

Plan Name:  
**PHASE I - EXISTING  
LOWER LEVEL  
FLOOR PLAN**

Drawing Number:  
**A1.002**  
Drawing 5 of 21

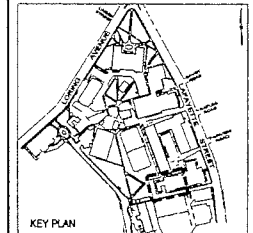

Project Name:  
 COST-REMOVAL  
 ALTERNATIVE  
 PROGRAM  
 SALEM STATE COLLEGE

MA State Project Number  
 SSA0701-DC1

Project Location  
 360 Lafayette Street  
 Salem, Massachusetts

Project Engineer



Project Number 10108.00

Project Consultant




Site Number: SSA00  
 CAMIS Number: SSA00  
 Building Number: 531SSC0340, Library  
 Secretariat: Dept. of Higher Education

Original Issue Date  
 09 - 13 - 2010

Revisions  
 No. Description Date  
 1 SKC-1 2-15-11

Plan Name:  
 PHASE I - EXISTING  
 FIRST FLOOR PLAN

Drawing Number:  
**A1.003**  
 Drawing 6 of 21

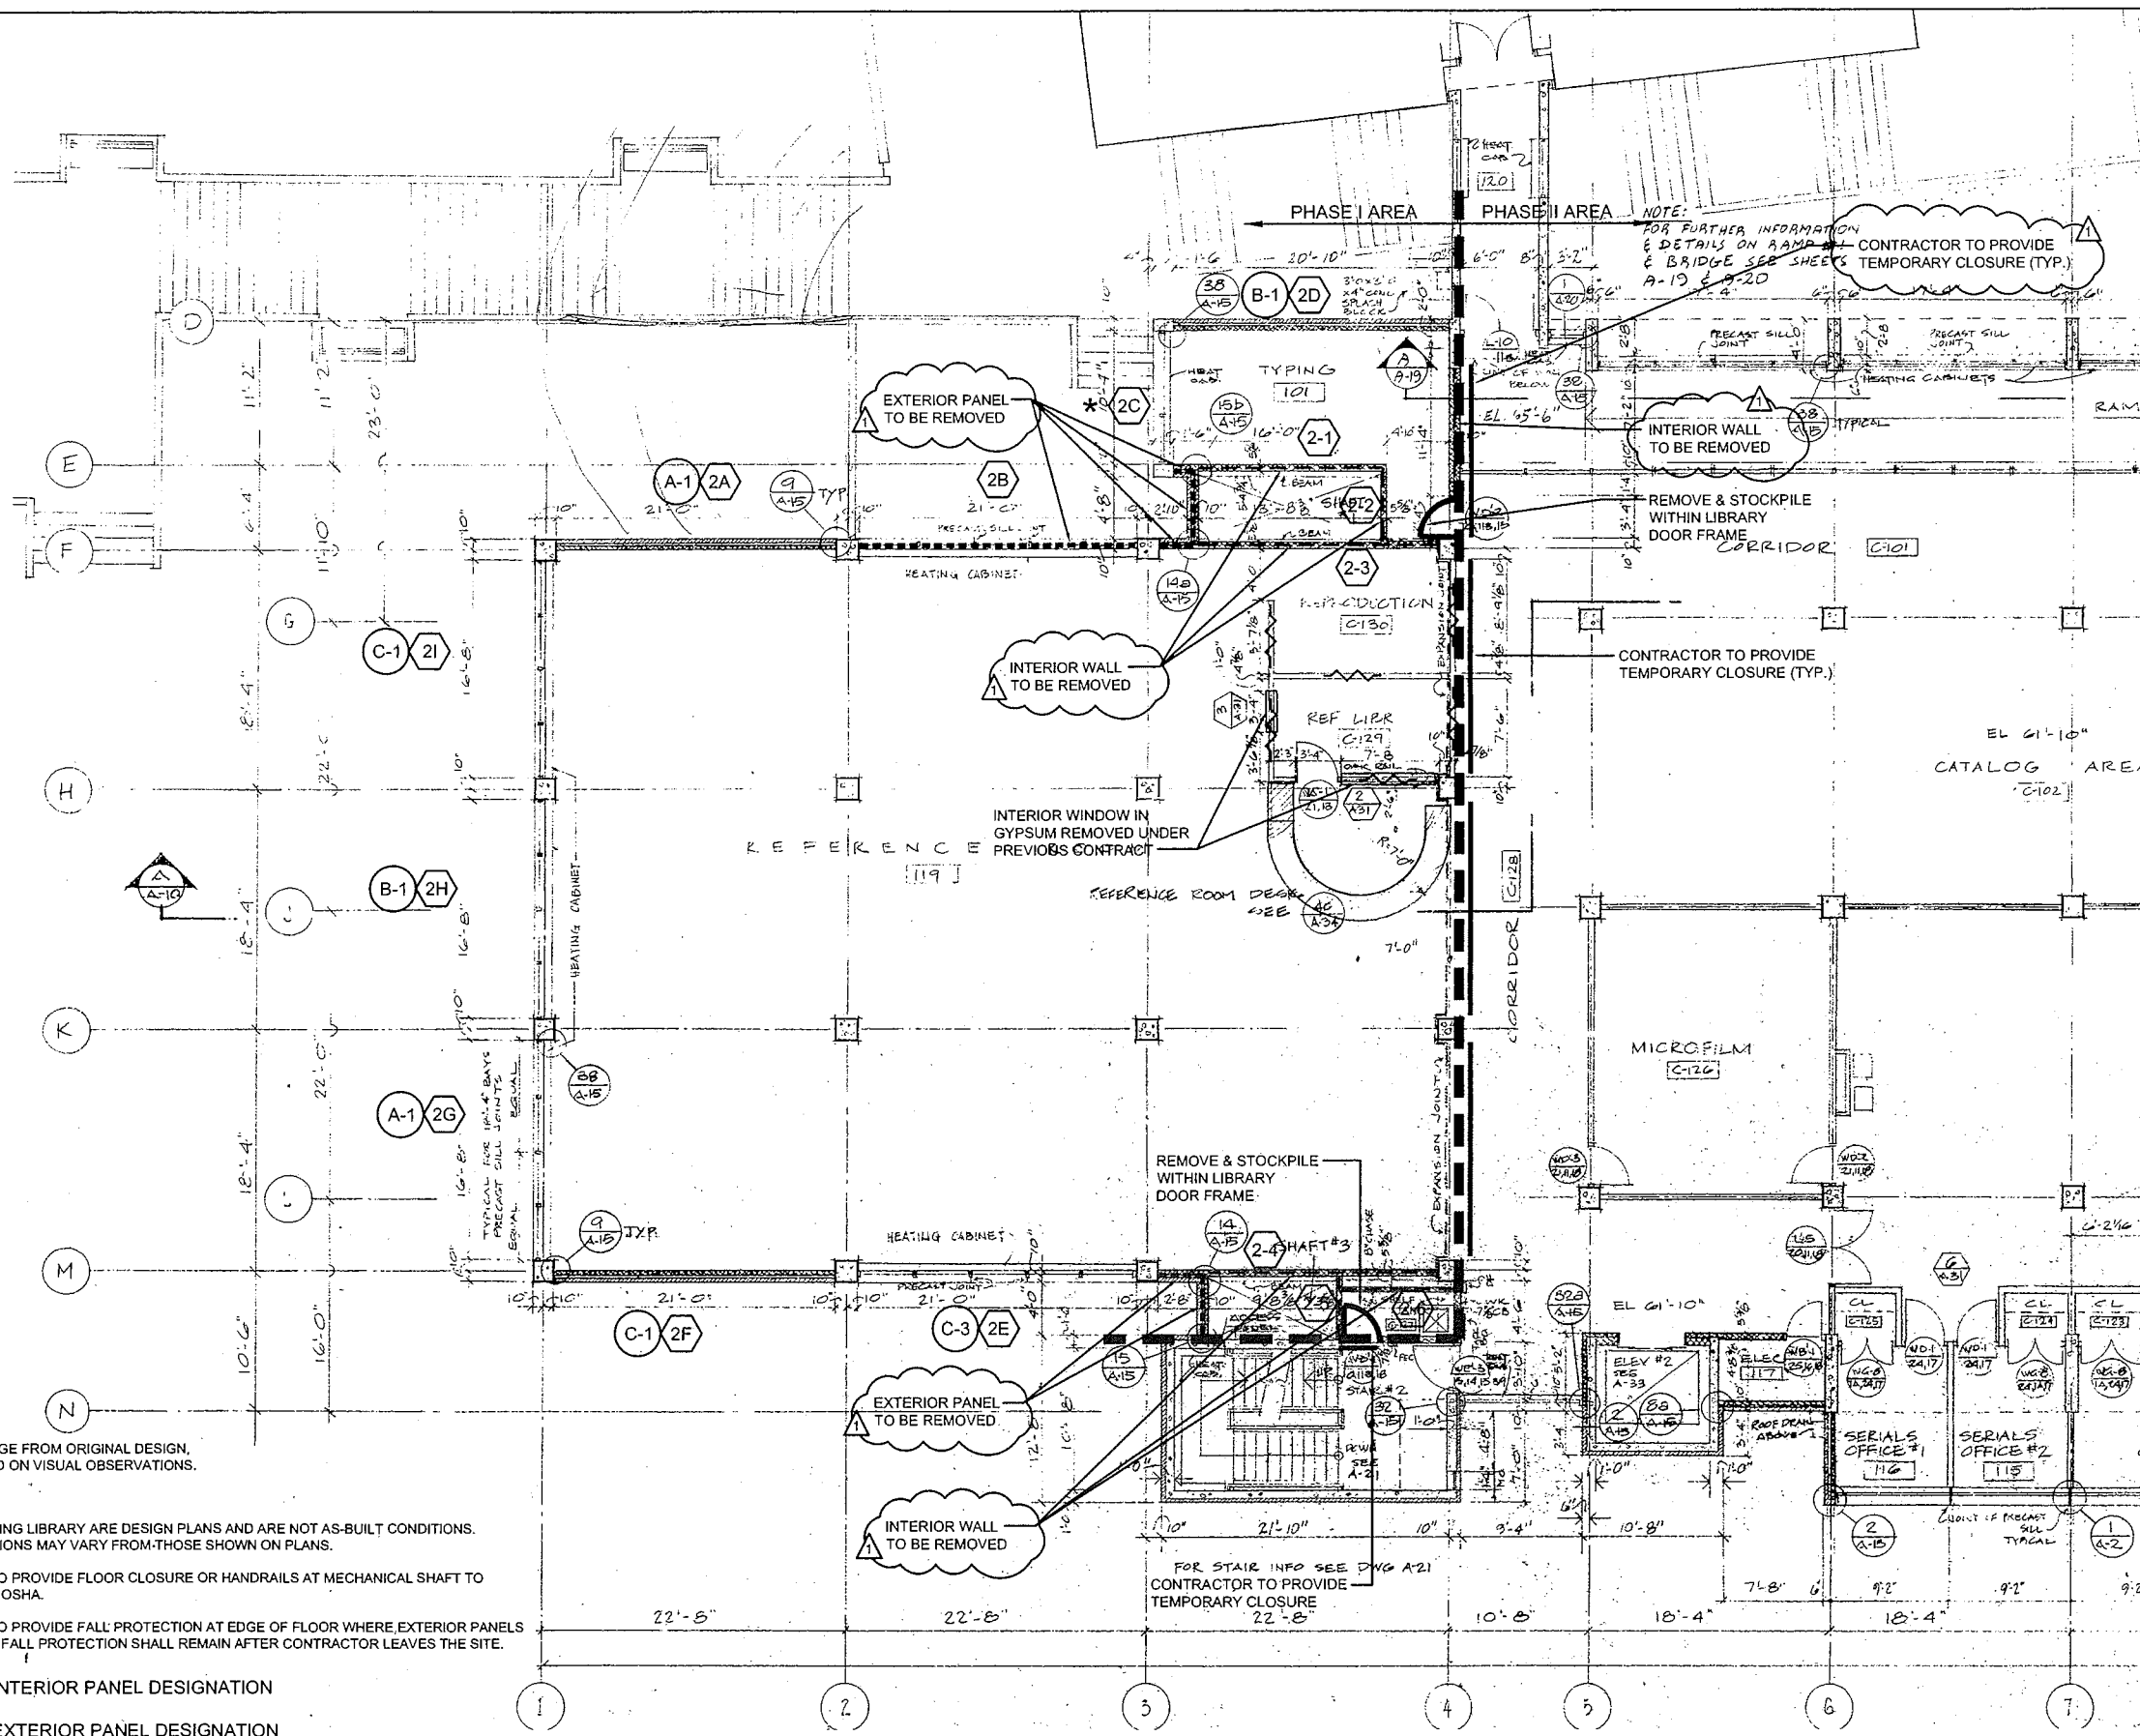

**LEGEND:**  
 [Dashed Line] CHANGE FROM ORIGINAL DESIGN, BASED ON VISUAL OBSERVATIONS.

**PLAN NOTES:**


- PLANS OF EXISTING LIBRARY ARE DESIGN PLANS AND ARE NOT AS-BUILT CONDITIONS. ACTUAL CONDITIONS MAY VARY FROM THOSE SHOWN ON PLANS.
- CONTRACTOR TO PROVIDE FLOOR CLOSURE OR HANDRAILS AT MECHANICAL SHAFT TO CONFORM WITH OSHA.
- CONTRACTOR TO PROVIDE FALL PROTECTION AT EDGE OF FLOOR WHERE EXTERIOR PANELS ARE REMOVED. FALL PROTECTION SHALL REMAIN AFTER CONTRACTOR LEAVES THE SITE.

- 1-5 INTERIOR PANEL DESIGNATION
- 1G EXTERIOR PANEL DESIGNATION
- A-1 PANEL TO BE REMOVED
- METHOD OF REMOVAL (LETTER DESIGNATES METHOD - NUMBER DESIGNATES TRIAL)
- ⊗ REMOVE INTERIOR CMU WALL UNDER THIS CONTRACT
- ~~~~~ GYPSUM WALL REMOVED UNDER PREVIOUS CONTRACT
- \* GLASS PANELS TO BE REMOVED

**ELEVATION DATUM:**  
 ELEVATIONS ON CIVIL (C-SERIES) DRAWINGS IN THIS CONTRACT REFER TO NGVD 1929. DEMOLITION (A-SERIES) DRAWINGS IN THIS CONTRACT SHOW ELEVATIONS REFERENCED TO A DATUM ABOUT 4.7 FEET BELOW NGVD 1929. ELEVATIONS ON THIS DRAWING CAN BE CONVERTED TO NGVD ELEVATIONS BY SUBTRACTING 4.7 FEET FROM THE VALUE SHOWN.





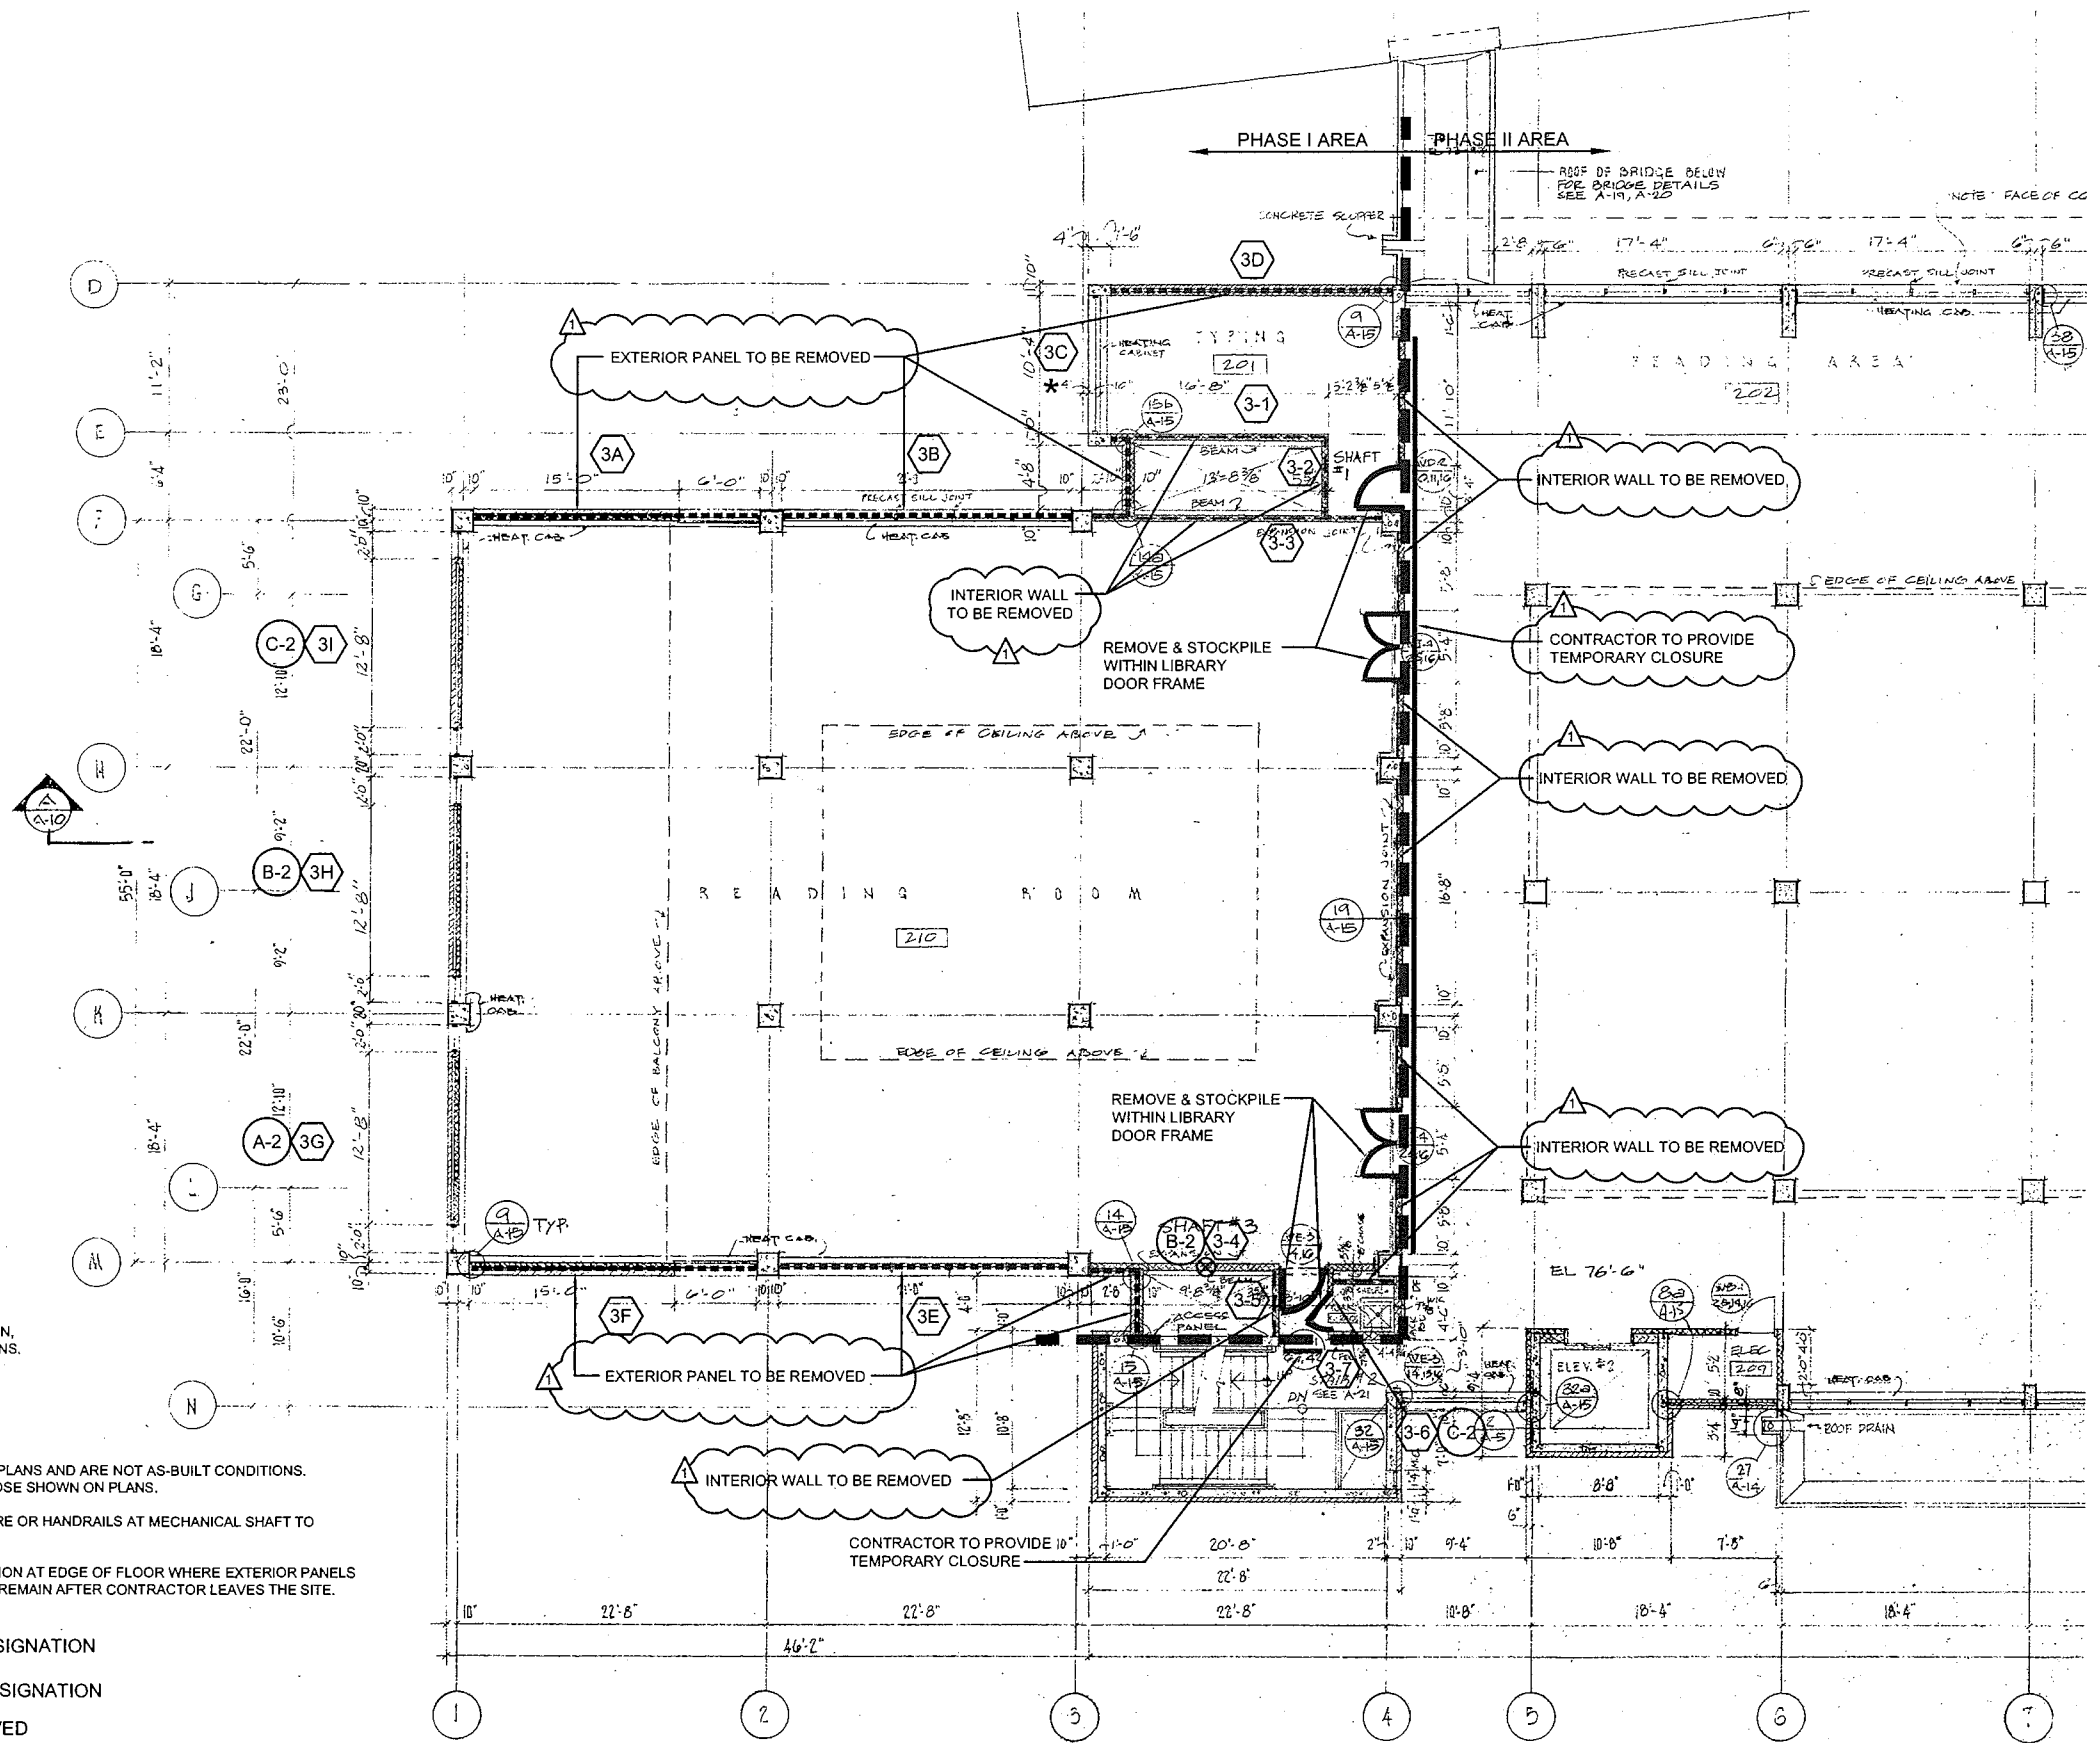

**LEGEND:**

CHANGE FROM ORIGINAL DESIGN, BASED ON VISUAL OBSERVATIONS.

- PLAN NOTES:**
1. PLANS OF EXISTING LIBRARY ARE DESIGN PLANS AND ARE NOT AS-BUILT CONDITIONS. ACTUAL CONDITIONS MAY VARY FROM THOSE SHOWN ON PLANS.
  2. CONTRACTOR TO PROVIDE FLOOR CLOSURE OR HANDRAILS AT MECHANICAL SHAFT TO CONFORM WITH OSHA.
  3. CONTRACTOR TO PROVIDE FALL PROTECTION AT EDGE OF FLOOR WHERE EXTERIOR PANELS ARE REMOVED. FALL PROTECTION SHALL REMAIN AFTER CONTRACTOR LEAVES THE SITE.

- 1-5 INTERIOR PANEL DESIGNATION
- 1G EXTERIOR PANEL DESIGNATION
- A-1 PANEL TO BE REMOVED METHOD OF REMOVAL (LETTER DESIGNATES METHOD - NUMBER DESIGNATES TRIAL)
- ⊗ REMOVE INTERIOR CMU WALL UNDER THIS CONTRACT
- ~~~~~ GYPSUM WALL REMOVED UNDER PREVIOUS CONTRACT
- \* GLASS PANELS TO BE REMOVED

**ELEVATION DATUM:**


ELEVATIONS ON CIVIL (C-SERIES) DRAWINGS IN THIS CONTRACT REFER TO NGVD 1929. DEMOLITION (A-SERIES) DRAWINGS IN THIS CONTRACT SHOW ELEVATIONS REFERENCED TO A DATUM ABOUT 4.7 FEET BELOW NGVD 1929. ELEVATIONS ON THIS DRAWING CAN BE CONVERTED TO NGVD ELEVATIONS BY SUBTRACTING 4.7 FEET FROM THE VALUE SHOWN.

APPROXIMATE SCALE, FEET

Division of Capital Asset Management  
**D.C.A.M.**  
 Building for the Commonwealth

Office of Planning  
 Design and Construction

McCormack Building  
 One Ashburton Place  
 Boston MA 02108  
 617 727 4050  
 www.mass.gov/cam

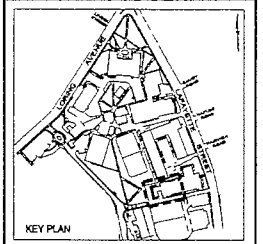

Project Name:  
**COST-REMOVAL  
 ALTERNATIVE  
 PROGRAM**  
 SALEM STATE COLLEGE

MA State Project Number  
 SSA0701-DC1

Project Location  
 360 Lafayette Street  
 Salem, Massachusetts

Project Engineer

**PARE** CORPORATION  
 ENGINEERS - ARCHITECTS - PLANNERS  
 11 UNION ROAD, SUITE 100  
 PORTLAND, ME 04106  
 207.853.1178

Project Number: 10108.00

Project Consultant

**PARE** CORPORATION  
 ENGINEERS - ARCHITECTS - PLANNERS  
 11 UNION ROAD, SUITE 100  
 PORTLAND, ME 04106  
 207.853.1178


Site Number: SSA00  
 CAMS Number: SSA00  
 Building Number: 531SSC0340, Library  
 Secretariat: Dept. of Higher Education

Original Issue Date  
 09 - 13 - 2010

| Revisions | No.   | Description | Date    |
|-----------|-------|-------------|---------|
| 1         | SKC-1 |             | 2-15-11 |

Plan Name:  
**PHASE I - EXISTING  
 SECOND FLOOR PLAN**

Drawing Number:  
**A1.004**  
 Drawing 7 of 21

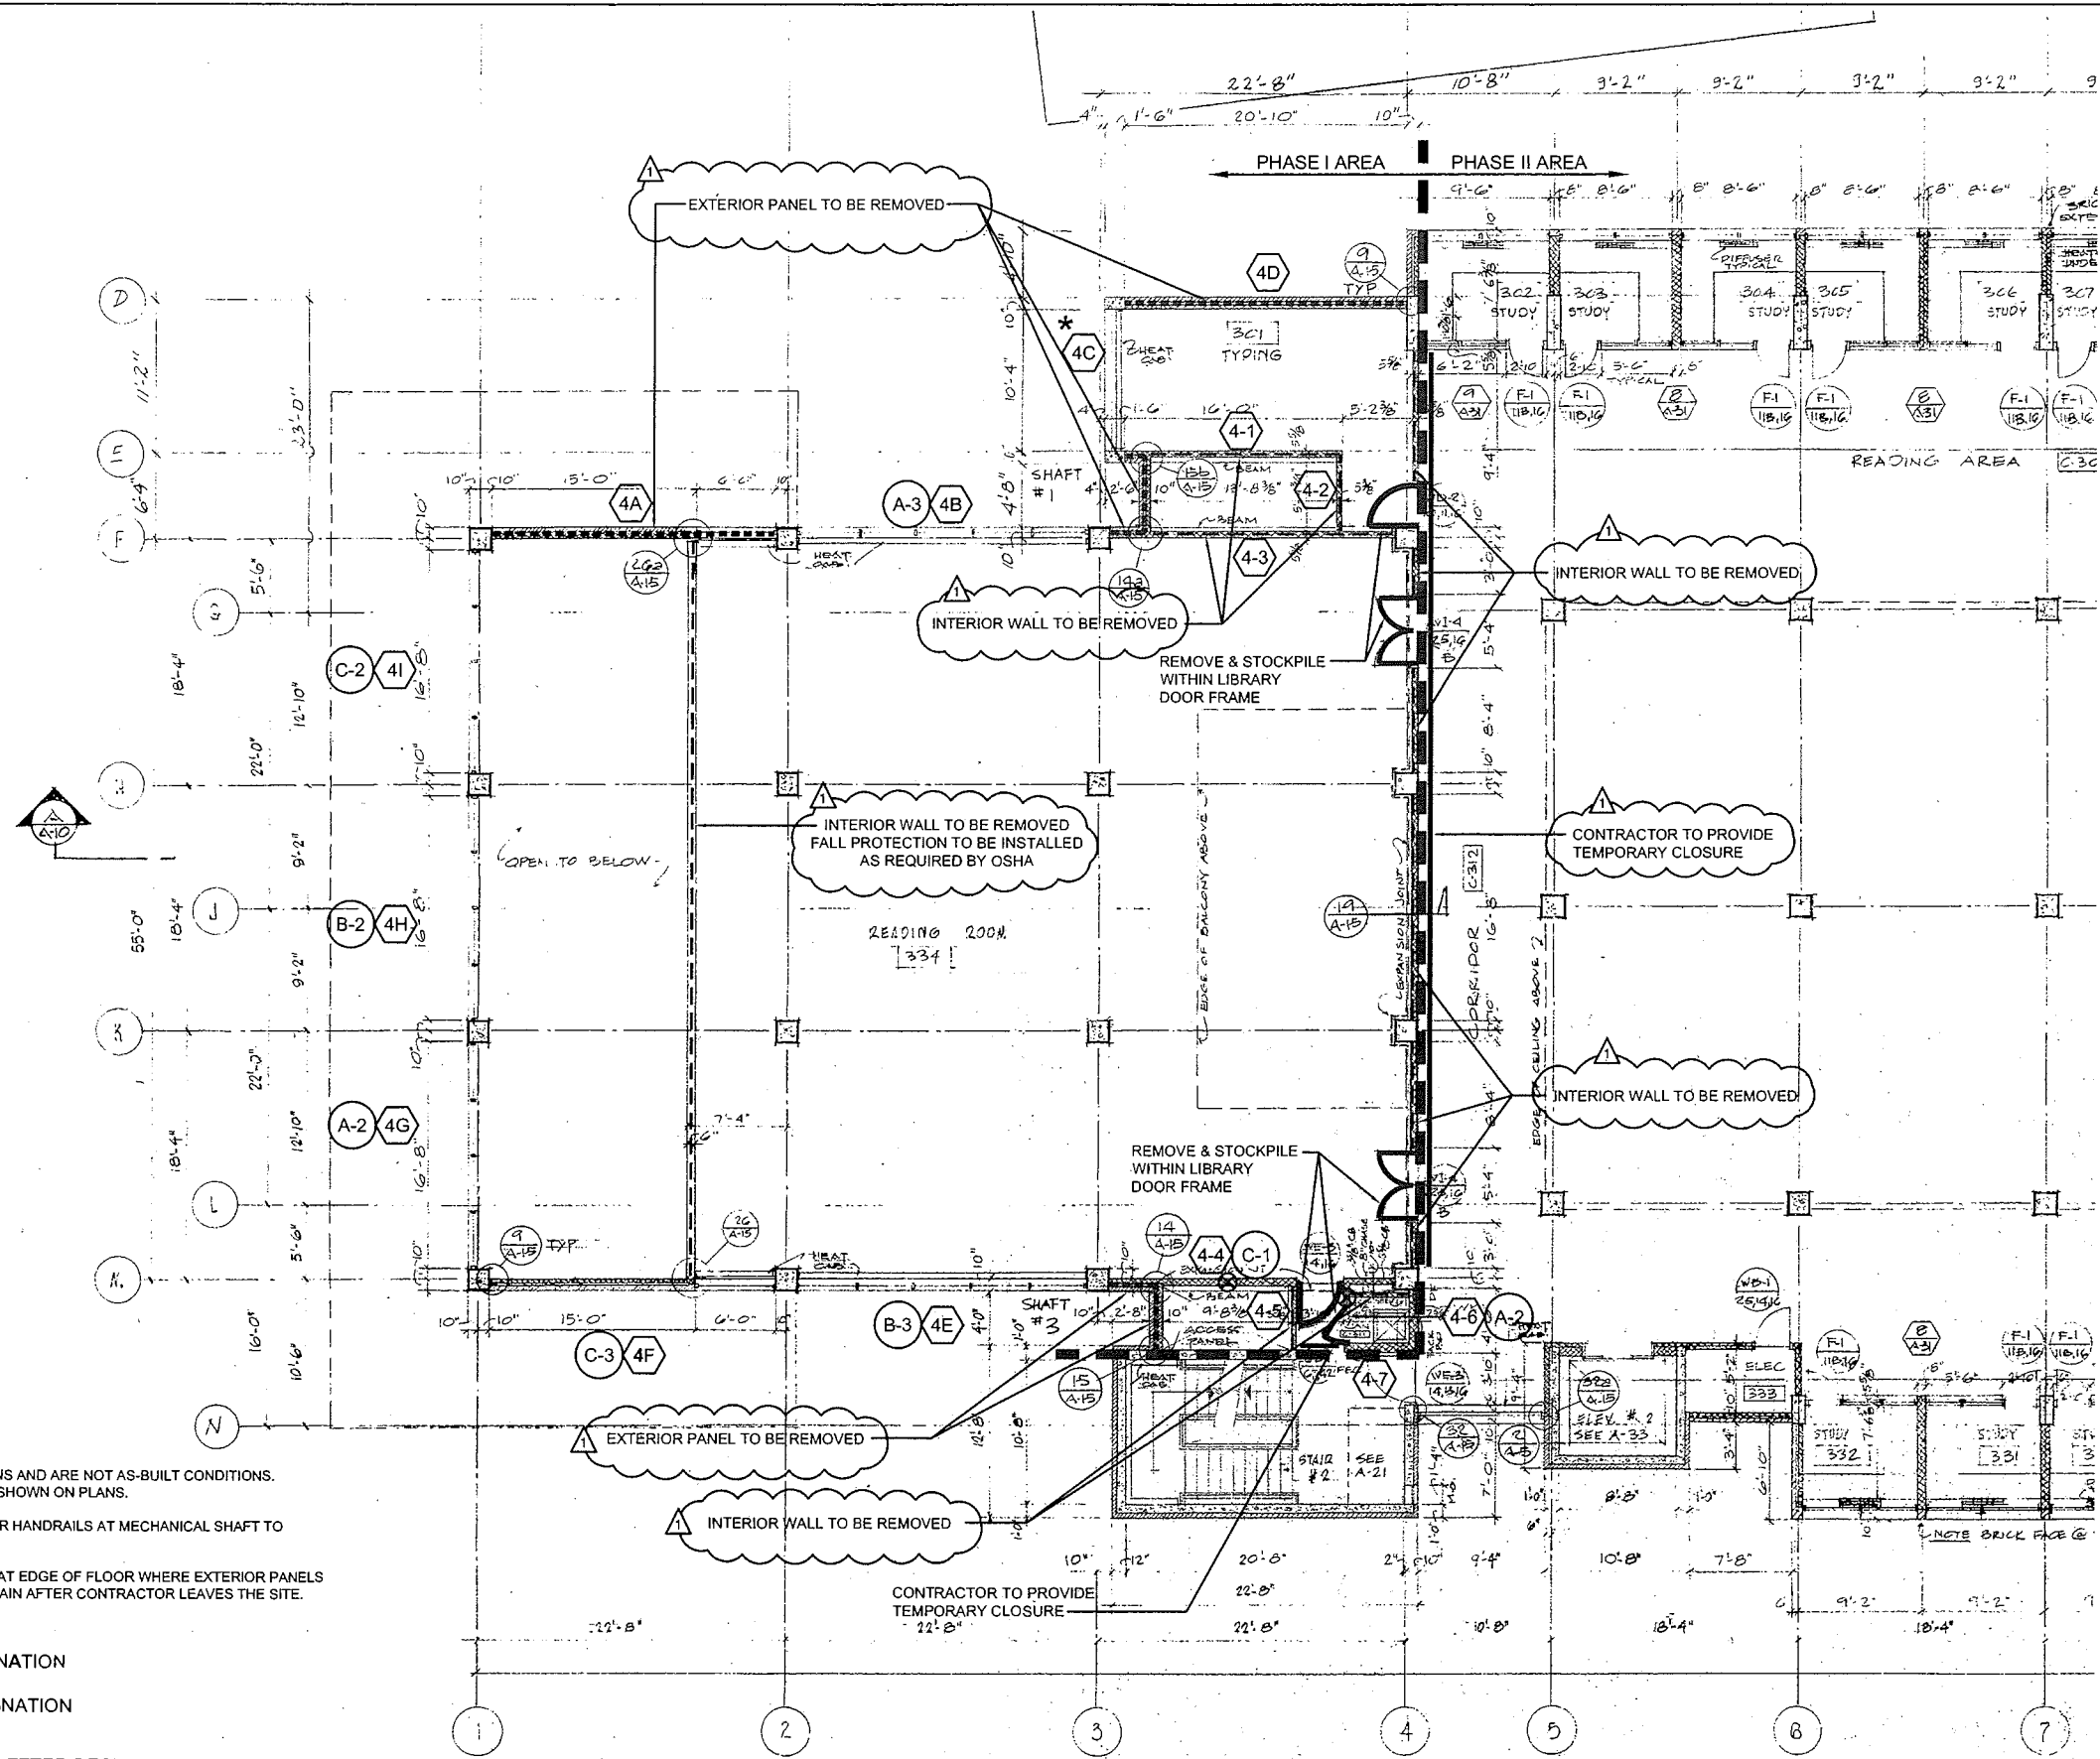

# **LEGEND:**

CHANGE FROM ORIGINAL DESIGN, BASED ON VISUAL OBSERVATIONS.

## **PLAN NOTES:**


- PLANS OF EXISTING LIBRARY ARE DESIGN PLANS AND ARE NOT AS-BUILT CONDITIONS. ACTUAL CONDITIONS MAY VARY FROM THOSE SHOWN ON PLANS.
- CONTRACTOR TO PROVIDE FLOOR CLOSURE OR HANDRAILS AT MECHANICAL SHAFT TO CONFORM WITH OSHA.
- CONTRACTOR TO PROVIDE FALL PROTECTION AT EDGE OF FLOOR WHERE EXTERIOR PANELS ARE REMOVED. FALL PROTECTION SHALL REMAIN AFTER CONTRACTOR LEAVES THE SITE.

- 1-5 INTERIOR PANEL DESIGNATION
- 1G EXTERIOR PANEL DESIGNATION
- A-1 PANEL TO BE REMOVED METHOD OF REMOVAL (LETTER DESIGNATES METHOD - NUMBER DESIGNATES TRIAL)
- ⊗ REMOVE INTERIOR CMU WALL UNDER THIS CONTRACT
- ~~~~~ GYPSUM WALL REMOVED UNDER PREVIOUS CONTRACT
- \* GLASS PANELS TO BE REMOVED

## **ELEVATION DATUM:**

ELEVATIONS ON CIVIL (C-SERIES) DRAWINGS IN THIS CONTRACT REFER TO NGVD 1929. DEMOLITION (A-SERIES) DRAWINGS IN THIS CONTRACT SHOW ELEVATIONS REFERENCED TO A DATUM ABOUT 4.7 FEET BELOW NGVD 1929. ELEVATIONS ON THIS DRAWING CAN BE CONVERTED TO NGVD ELEVATIONS BY SUBTRACTING 4.7 FEET FROM THE VALUE SHOWN.

Division of Capital Asset Management  
**D·C·A·M**  
 Building for the Commonwealth  
 Office of Planning  
 Design and Construction  
 McCormack Building  
 One Ashburton Place  
 Boston MA 02108  
 617 727 4050  
 www.mass.gov/cam

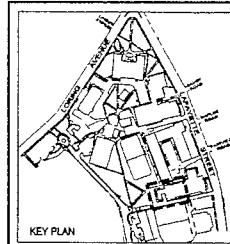

Project Name:  
**COST-REMOVAL  
 ALTERNATIVE  
 PROGRAM  
 SALEM STATE COLLEGE**

MA State Project Number  
**SSA0701-DC1**

Project Location  
 360 Lafayette Street  
 Salem, Massachusetts

## **Project Engineer**

**PARE** CORPORATION  
 ENGINEERS - ARCHITECTS - PLANNERS  
 10 LAFAYETTE STREET, SUITE 200  
 SALEM, MA 01970  
 978-744-1771

Project Number 10108.00

## **Project Consultant**

**PARE** CORPORATION  
 DESIGNERS - ENGINEERS - PLANNERS  
 10 LAFAYETTE STREET, SUITE 200  
 SALEM, MA 01970  
 978-744-1771

Site Number: SSA60  
 CAMIS Number: SSA00  
 Building Number: 531SSC0340, Library  
 Secretariat: Dept. of Higher Education

Original Issue Date  
**09 - 13 - 2010**


Revisions  
 No. Description Date  
 1 SKC-1 2-15-11

## **Plan Name:**

**PHASE I - EXISTING  
 THIRD FLOOR PLAN**

## **Drawing Number:**

**A1.005**  
 Drawing 8 of 21

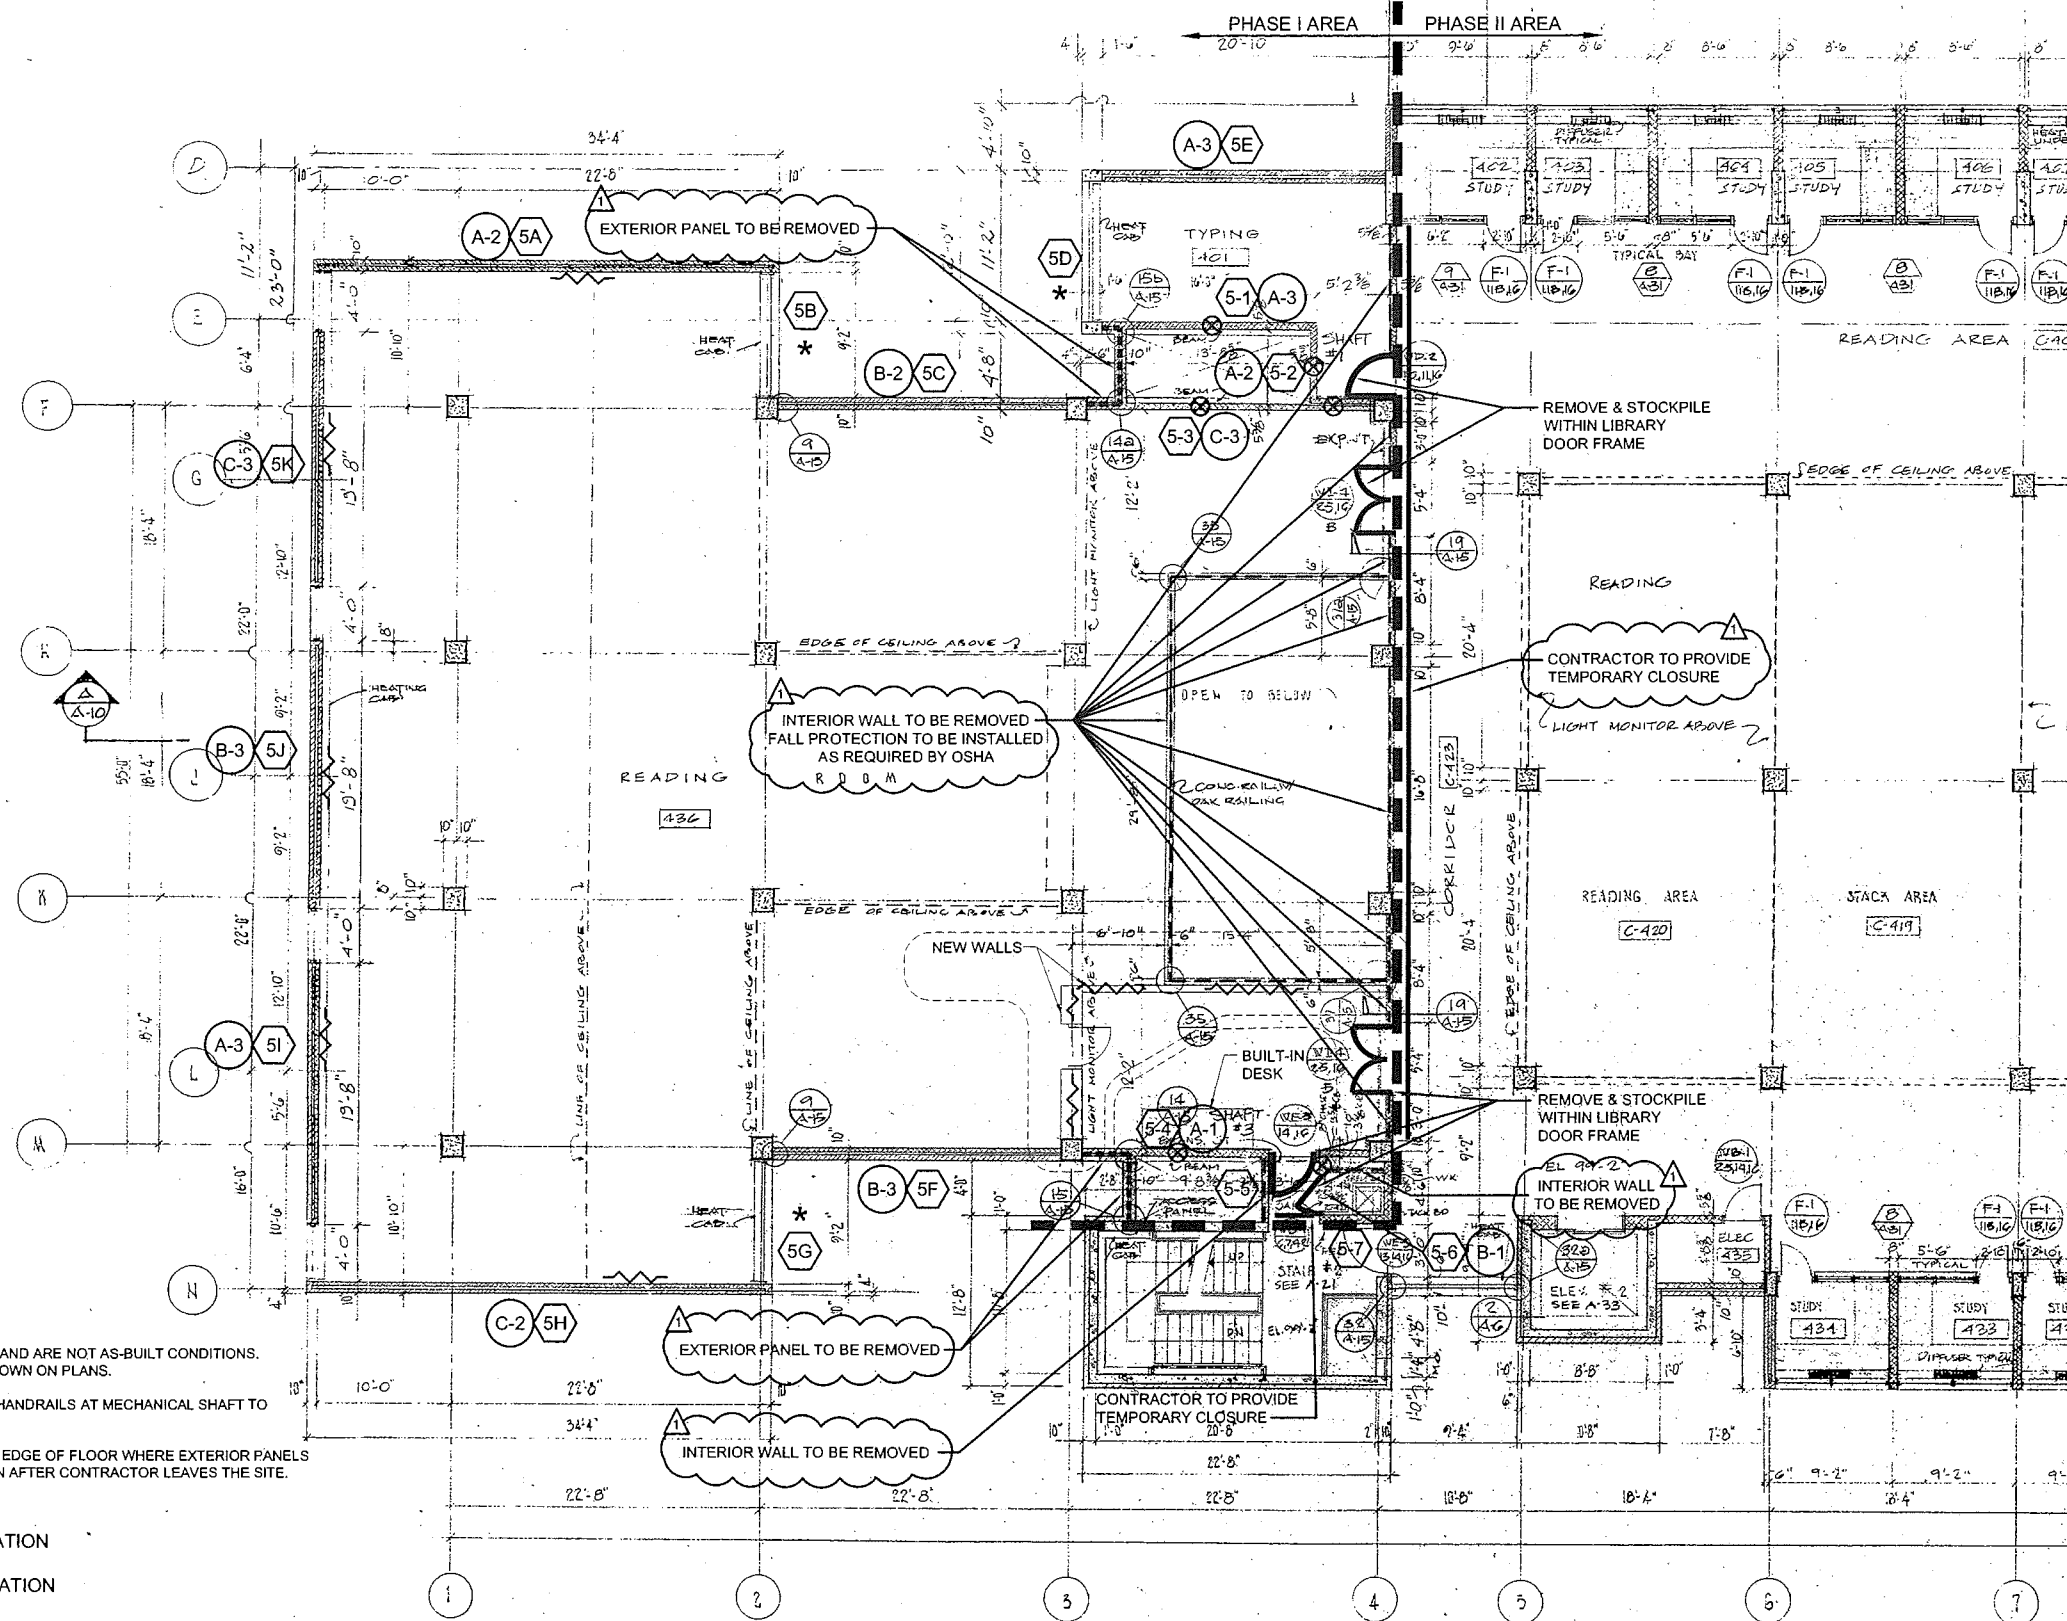

**LEGEND:**

CHANGE FROM ORIGINAL DESIGN, BASED ON VISUAL OBSERVATIONS.

- PLAN NOTES:**
1. PLANS OF EXISTING LIBRARY ARE DESIGN PLANS AND ARE NOT AS-BUILT CONDITIONS. ACTUAL CONDITIONS MAY VARY FROM THOSE SHOWN ON PLANS.
  2. CONTRACTOR TO PROVIDE FLOOR CLOSURE OR HANDRAILS AT MECHANICAL SHAFT TO CONFORM WITH OSHA.
  3. CONTRACTOR TO PROVIDE FALL PROTECTION AT EDGE OF FLOOR WHERE EXTERIOR PANELS ARE REMOVED. FALL PROTECTION SHALL REMAIN AFTER CONTRACTOR LEAVES THE SITE.

- LEGEND:**
- 1-5 INTERIOR PANEL DESIGNATION
  - 1G EXTERIOR PANEL DESIGNATION
  - A-1 PANEL TO BE REMOVED METHOD OF REMOVAL (LETTER DESIGNATES METHOD - NUMBER DESIGNATES TRIAL)
  - ⊗ REMOVE INTERIOR CMU WALL UNDER THIS CONTRACT
  - ~~~~~ GYPSUM WALL REMOVED UNDER PREVIOUS CONTRACT
  - \* GLASS PANELS TO BE REMOVED

**ELEVATION DATUM:**


ELEVATIONS ON CIVIL (C-SERIES) DRAWINGS IN THIS CONTRACT REFER TO NGVD 1929. DEMOLITION (A-SERIES) DRAWINGS IN THIS CONTRACT SHOW ELEVATIONS REFERENCED TO A DATUM ABOUT 4.7 FEET BELOW NGVD 1929. ELEVATIONS ON THIS DRAWING CAN BE CONVERTED TO NGVD ELEVATIONS BY SUBTRACTING 4.7 FEET FROM THE VALUE SHOWN.

APPROXIMATE SCALE, FEET

Division of Capital Asset Management  
**D.C.A.M.**  
 Building for the Commonwealth

Office of Planning  
 Design and Construction

McCormack Building  
 One Ashburton Place  
 Boston MA 02108  
 617 727 4050  
 www.mass.gov/cam

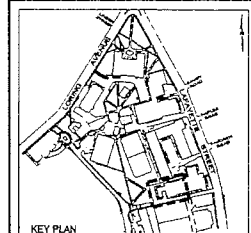

Project Name:  
**COST-REMOVAL  
 ALTERNATIVE  
 PROGRAM  
 SALEM STATE COLLEGE**

MA State Project Number  
 SSA0701-DC1

Project Location  
 360 Lafayette Street  
 Salem, Massachusetts

Project Engineer  
**PARE CORPORATION**  
 ENGINEERS - ARCHITECTS - PLANNERS  
 10 LINCOLN ROAD, SUITE 200  
 FARMINGTON, CT 06030  
 860-634-1170

Project Consultant  
**PARE CORPORATION**  
 ENGINEERS - ARCHITECTS - PLANNERS  
 10 LINCOLN ROAD, SUITE 200  
 FARMINGTON, CT 06030  
 860-634-1170

Site Number: SSA00  
 CAMIS Number: SSA00  
 Building Number: 5315SC0340, Library  
 Secretariat: Dept. of Higher Education

Original Issue Date  
 09 - 13 - 2010

Revisions  
 No. Description Date  
 1 SKC-1 2-15-11

Plan Name:  
**PHASE I - EXISTING  
 FOURTH FLOOR PLAN**

Drawing Number:  
**A1.006**  
 Drawing 9 of 21



Drawing Number:  
**A1.008**  
Drawing 11 of 21